


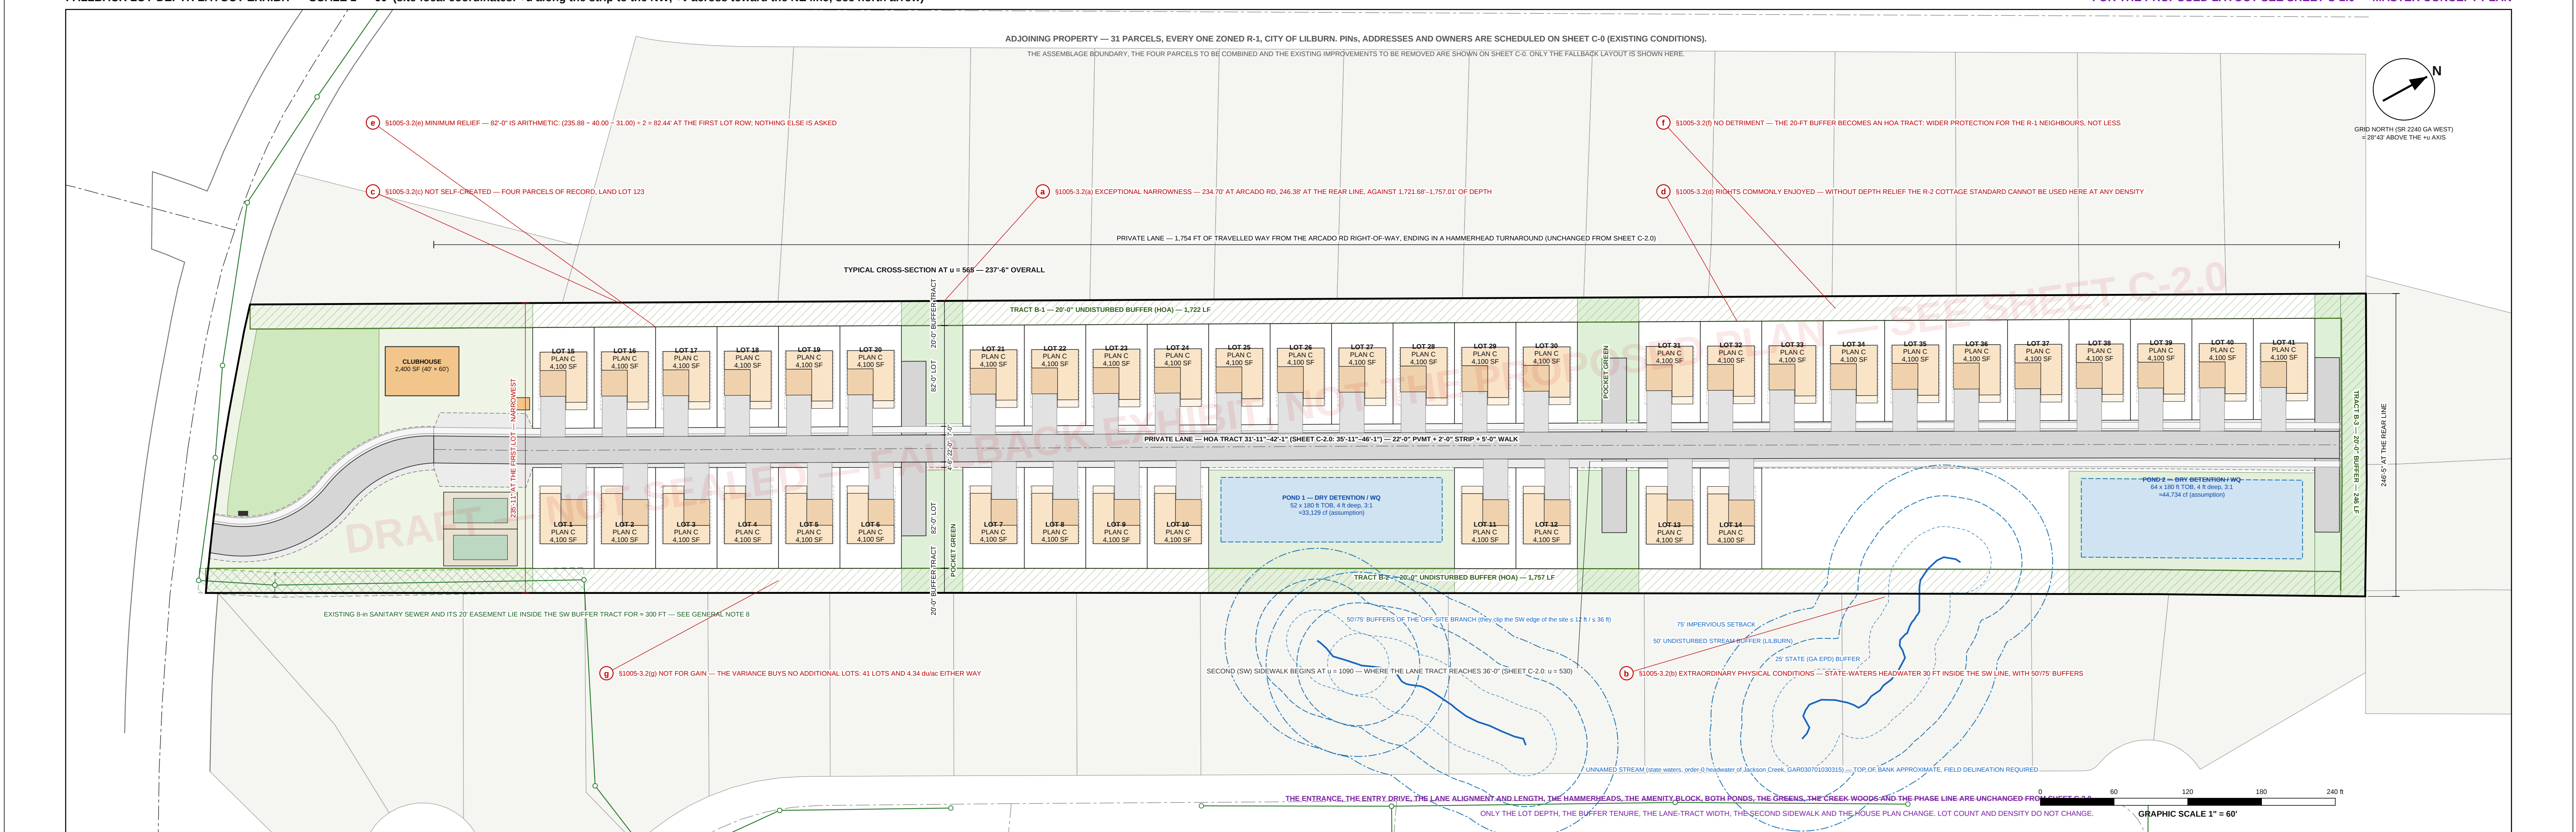

SIDE-BY-SIDE COMPARISON — the two readings of Ord. 2023-603 §313(1), priced

ITEM	SHEET C-2.0 — §313(1) BUFFER INSIDE THE LOT	THIS SHEET C-2.4 — BUFFER IN A SEPARATE TRACT
Buffer against R-1	20'-0" undisturbed buffer inside the rear 20 ft of every perimeter lot, in a recorded buffer easement (§313(1) reading)	20'-0" undisturbed buffer in separate HOA-owned Tracts B-1 / B-2 / B-3 — 73,697 SF
Typical lot	80'-0" × 100'-0" = 5,000 SF	50'-0" × 82'-0" = 4,100 SF
Table 4.1 lot area (3,000 SF min.)	5,000 SF — appears consistent	4,100 SF — appears consistent
Table 4.1 lot width (50 ft min.)	50'-0" — appears consistent	50'-0" — appears consistent
Table 4.1 lot depth (100 ft min.)	100'-0" — appears consistent	82'-0" — VARIANCE REQUIRED (§1005)
Loss	41 (14 SW + 27 NE)	41 (14 SW + 27 NE) — unchanged
Density (B dual max.)	4.34 du/acre (deeded) / 4.28 GIS	4.34 du/acre (deeded) / 4.28 GIS — unchanged
Buildable body depth	100' — 15' — 20' = 65'-0" less the 6-ft porch = 59'-0"	82' — 15' — 20' = 47'-0" less the 6-ft porch = 41'-0"
House plans that fit	Plan A 38'-0" × 51'-0"; Plan B 38'-0" × 57'-0"	NETHER — a third plan is required: Plan C 38'-0" × 41'-0"
Conditioned area	1,406 SF (Plan A) / 1,492 SF (Plan B)	1,032 SF (Plan C) — 12 SF above the 1,000-SF Table 4.1 minimum
Total under roof	1,966 SF / 7,182 SF	1,555 SF
Rear amenity	Plan A 6'-0" patio; Plan B 34'-0" covered rear porch	None within the 20-ft rear yard; uncovered patio shown dashed — VERIFY
Private lane tract	35'-11" — 46'-1"; 22-ft pavement, symmetrical	31'-11" — 42'-1"; 22-ft pavement set 18'-0" from the NE tract line
Second (SW) sidewalk	From u = 530 (= 1,170 ft)	From u = 1,090 (= 610 ft)
Common open space	141,089 SF = 33.8% of GIS area, plus 41,000 SF of buffer easement on lots reported separately	183,893 SF = 44.1% of GIS area, including the 73,697-SF buffer tracts; no buffer easement on any lot
Impervious area	184,148 SF = 44.1% of GIS area	157,158 SF = 37.7% of GIS area (Plan C is smaller)
Water-quality volume WQv	16,659 cf	16,230 cf
Disturbed area / detention	7.54 ac; 76,410 cf required; 77,863 cf provided	Unchanged — the preserved buffer bands and creek woods are identical
Fire access	41 units — under the 120-unit trigger of IFC 2024 (GA) App. D107.1 as amended by Ga. Comp. R. & Regs. 120-3-3-.04, D103.4 special approval for the dead end Phase 1 in the existing on-site 8-in main; Phase 2 by the = 178-ft off-site gravity tie	Unchanged
Sanitary sewer	Unchanged	Unchanged
Approvals needed	Rezoning R-1 → R-2, plus a favorable §313(1) interpretation by the Planning Director	Rezoning R-1 → R-2, plus a concurrent §1005 variance on lot depth decided by Mayor and Council with the companion application
Filing cost	\$1,250 rezoning fee (City of Lilburn FY2026-2027 Fee Schedule, Res. 2026-08-31, 2026-08-31)	\$1,250 + \$500 variance hearing fee (+\$25 for each additional variance) on the same property) — confirm the adopted amounts at filing
Principal risk	The §313(1) reading may be rejected. Article 3 sets no buffer widths and the ordinance nowhere authorizes a required buffer inside a private lot	A variance is discretionary; the applicant must carry every §1005-3.2 criterion at the hearing

Every figure in the right-hand column is computed by tools/fallback.py from the same boundary, entrance and lane geometry as Sheet C-2.0.

LEGEND — every symbol drawn on this sheet

Assemblage boundary (GIS — DRAFT)

Arcado Rd right-of-way line

Existing road centerline

20'-0" perimeter buffer tract (HOA)

Fallback lot line — 50' × 82' = 4,100 SF

Building setback line 15 / 5 / 20

Plan C dwelling — SCHEMATIC

2-car garage, recessed 5'-0"

Covered front porch 6'-0"

Driveway 20'-0" × 26'-0"

Private lane / entry drive tract (HOA)

Pavement and hammerhead turnaround

Guest / mail-kiosk parking stall 9' × 18'

Sidewalk 5'-0"

Lane centerline (fallback alignment)

Pocket / terminus green (unchanged)

Front amenity tract (unchanged)

Village green (unchanged)

Chainhouse and mail kiosk (unchanged)

Pickelball pad (unchanged)

Pickelball court surface (unchanged)

Monument entry sign (unchanged)

Stormwater pond tract (unchanged)

Dry detention / WQ basin (unchanged)

Stream — state waters (top of bank approx.)

25' state (GA EPD) buffer

50' undisturbed stream buffer

75' impervious setback

Existing 8-in sanitary sewer and manhole

Existing 20' sanitary sewer easement

§1005-3.2 criterion key (a) — (g)

Dimension line and tick

Existing contours, vegetation, structures, utilities, soils and the adjoining owner schedule are on Sheet C-0 and are not repeated here.

CONCURRENT VARIANCE — Ord. 2023-603 §1005, lot depth 100'-0" — 82'-0" (criteria §1005-3.2 (a)–(g), keyed on the plan)

KEY	CRITERION (SUBJECT — VERIFY)	APPLICANT'S RESPONSE
a	Exceptional narrowness.	The assemblage is a strip 234'-0" wide at the Arcado Rd right-of-way, 235'-11" at the first lot row (u = 230) and 246'-0" at the rear line, against 1,757'-0" of depth on the SW line and 1,722'-0" on the NE line — about 7.3 : 1. Take a 20-ft buffer tract off each side (40 ft) and the 31-ft minimum private-lane section that City of Lilburn Site Development Plan Review Checklist §4.4 ("all components of private streets... must meet minimum standards for public street") requires, and 164'-11" of width is left for two facing rows of lots — 82'-0" each. No arrangement of a 100-ft-deep lot fits. An unnamed order-0 headwater of Jackson Creek (state waters) reaches about 30 ft inside the SW line and carries 25-ft state, 50-ft undisturbed and 75-ft impervious setbacks, a ridge at u = 1,090–1,200 divides the sanitary basins; the only public frontage is 27.63 ft of Arcado Rd, a county collector on which no lot may be driveway-served. The developable envelope is fixed before any lot is drawn.
b	Extraordinary and exceptional physical conditions	R-1 lots "Single family (cluster-cottage, creative lot configurations)" as a permitted use (§602) and sets a 3,000-SF, 50-ft-cottage lot in Table 4.1. If the buffer must sit in its own tract, the 100-ft depth rule makes that permittee unworkable here at any density — the district standard the property is being rezoned to use cannot be used.
c	The condition is not the result of any action by the applicant	Relief is 18 ft of depth (100 ft — 82 ft, 18 ft), and 82 ft is arithmetic, not preference: (235.88 – 2 × 20.00 – 31.00) + 2 = 82.44 ft. Nothing else is asked: lot area 4,100 SF (min. 3,000), lot width 50 ft (min. 50), density 4.34 du/acre (max. 4), front 15 ft, side 5 ft, rear 20 ft, height one story, buffer 20 ft — every one met as drawn.
d	Strict application deprives the owner of rights commonly enjoyed by other property in the district	The variance moves protection outward, not inward: the 20-ft buffer stops being a private easement inside a back yard and becomes 73,697 SF of HOA-owned undisturbed tract, shown on the plat with a no-disturbance restriction and a maintenance obligation (Checklist §4.4, §6.3). Common open space rises from 33.8% to 44.1% of the site and impervious area falls to 37.7%. Density, use, height, setbacks and the 55+ (HOA) condition are unchanged.
e	The variance requested is the minimum necessary	The variance yields no additional lots and no additional density: 41 lots and 4.34 du/acre either. Its only effect is to let the required buffer be held in the separate tract staff may require, at the cost of 900 SF of private lot area per home and a smaller house. The applicant would prefer the §313(1) reading and no variance at all.
f	Relief may be granted without substantial detriment to the public good and without impairing the purposes and intent of the ordinance	Unchanged
g	The relief sought is not necessary for financial advantage to the applicant	Unchanged


The letters (a) — (g) are keyed to the plan above in red. The adopted text of §1005-3.2 is NOT reproduced on this sheet — see General Note 5.

FALLBACK SITE DATA AND AREA TABULATION

ITEM	THIS SHEET (COMPUTED)	BASIS
Gross site area	417,174 SF = 9.577 ac (GIS; 9.44 ac: deeded)	data/fallback.json boundary, .ring, RLS survey geoids
Loss	41 × 4,100 SF = 168,100 SF (40.3%)	50'-0" × 82'-0", computed lot by lot (4,100–4,100 SF)
Private lane tract	57,725 SF	Residual between the two lot rows, 31'-11"–42'-1"
Entry drive tract	7,460 SF	Unchanged from Sheet C-2.0
Common open space (all HOA tracts)	183,893 SF = 4.22 ac = 44.1% of GIS / 44.7% of deeded	Residual: site less lots less the lane and entry-drive tracts
— of which perimeter buffer tracts	73,697 SF [B-1, NE 1,722 LF, B-2 SW 1,757 LF, B-3 rear 246 LF]	20'-0" mixed inward offset of the side and rear property lines
— of which amenity, greens, ponds, creek woods	110,190 SF	Unchanged tracts of Sheet C-2.0, less the area now inside the buffer tracts
Private easement on lots	0 SF (Sheet C-2.0: 4,100 SF)	The point of this sheet
Impervious area	157,158 SF = 37.7% of GIS area	Computed from the Plan C footprint and the drawn pavement — see the impervious schedule
Water-quality volume WQv	16,230 cf	GC5WMM, 1.2 × (0.05 × 0.009 × 37.7) × 12 × 417,174 SF
Detention required / provided	75,410 cf / 77,863 cf	Unchanged — 7.54 disturbed ac at 10,000 cfs/d
Parking	82 required, 164 on lot + 12 guest	Table § 1.2 per dwelling unit; 2 garage + 2 driveway per lot
Lot frontage on the lane	50'-0" every lot (30 ft required)	Ord. 2023-603 §319
Clearance, lots to the stream centerline	99'-6" minimum (Sheet C-2.0: 80.6 ft)	All three disgorged setbacks, top of bank not yet delineated


TYPICAL FALLBACK LOT — 50'-0" × 82'-0" (4,100 SF)

Scale 1" = 20'. Buffer in a separate HOA tract.

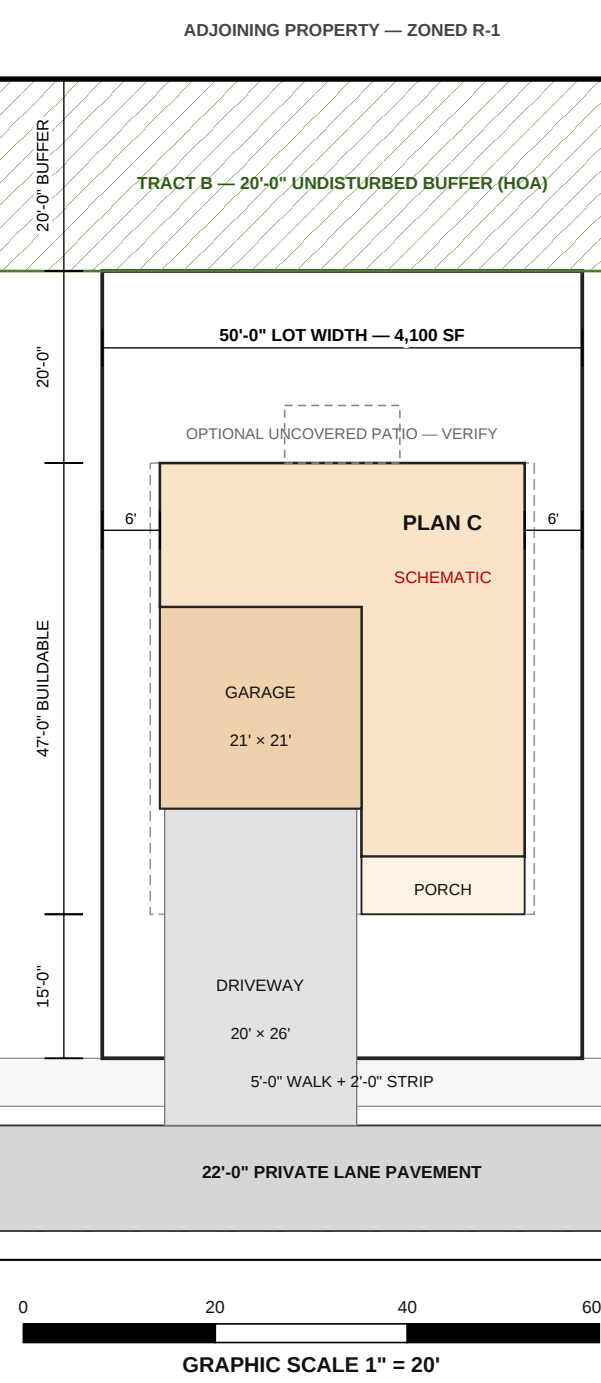

PLAN C — SCHEMATIC COTTAGE FOOTPRINT

Scale 3/32" = 1'-0". Block diagram only — SCHEMATIC, not a designed plan.

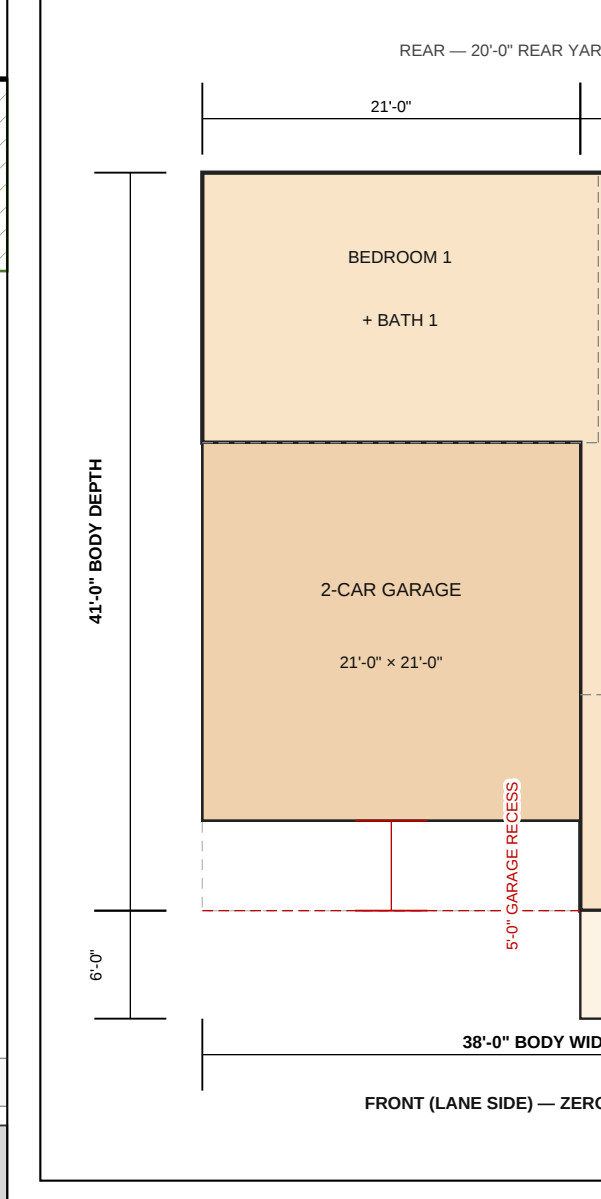

PLAN C — AREA TABULATION (SCHEMATIC)	AREA	BASIS
Conditioned — front wing 17'-0" × 26'-0"	442 SF	Outside face of exterior walls
Conditioned — rear block 36'-0" × 15'-0"	570 SF	Outside face of exterior walls
Total conditioned (related) floor area	1,012 SF	2 BR / 2 BA, one storey
Table 4.1 minimum, cottage home	1,000 SF	Margin +12 SF (= 1%)
2-car garage 21'-0" × 21'-0"	441 SF	Recessed 5'-0" (Table 4.2)
Covered front porch 17'-0" × 6'-0"	102 SF	Integral
Total under roof	1,555 SF	Conditioned + garage + porch
Building coverage on a 4,100-SF lot	37.9%	Under roof + lot
Impervious per lot	2,135 SF	Roof + 20' × 26' drive + entry
Ridge height (as Plans A and B)	± 24'-0"	One storey, Table 4.1, maximum 40 ft

Zero-step entry, 36-in doors, 5-ft turning circles and grab-bar blocking as Plans A and B.

GENERAL NOTES — FALLBACK LAYOUT

- STATUS OF THIS SHEET — IT IS NOT THE PROPOSED PLAN. The proposed layout is Sheet C-2.0, on which the 20-ft buffer required against the abutting R-1 property is held inside the rear 20 ft of each perimeter lot in a recorded buffer easement, under Lilburn Zoning Ordinance 2023-603 §313(1) ("buffer requirements... supersede these minimum required yards"). This sheet is the alternative that is built if the Planning Director of the City Attorney reads §313(1) as not authorizing a required buffer inside a private lot. Only one of the two layouts will be constructed, both are shown so the Commission and the Council can price the interpretation before it is made.
- WHY THE FALLBACK IS CARRIED. Two independent readings put the §313(1) basis in doubt: (i) §313(1) speaks of "buffer requirements established by this article" — Article 3 — and Article 3 lists no buffer width; the 20-ft buffer abutting R-1 comes from Table 4.1 in Article 4, a zoning rule in Ord. 2023-603 expressly authorizing a required buffer inside a private lot; (ii) The City of Lilburn Site Development Plan Review Checklist §6.3 reads "If a portion of required buffer is within an easement, provide 25' additional buffer outside easement", which on its face would add 25 ft outside any buffer easement held on a lot. Both are questions for the pre-application conference (Planning Director, 340 Main St).
- WHAT CHANGES AND WHAT DOES NOT. Unchanged: lot depth 100'-0" — 82'-0", buffer tenure (easement on lots — HOA tracts), house plan (Plans A and B — Plan C), private-lane tract width, the station at which the second sidewalk begins. Unchanged: the boundary, the entrance at v = -190 and the 24-ft entry drive, the lane alignment, the one-story height, the use, and the 55+ (HOA) condition. LOT COUNT AND DENSITY DO NOT CHANGE: 41 lots at 4.34 du/acre on 9.44 deeded acres, well under the 8 du/acre maximum of Table 4.1. Yield here is set by frontage on the single line, not by lot depth — the same 41 fifty-foot lots from the same travelled way in both layouts — so the shallower lot returns 900 SF per lot to common open space and takes nothing off the unit count.
- THE VARIANCE REQUESTED. Table 4.1 sets a minimum lot depth of 100 ft for ALL uses in R-2, with no cottage-home exception, so 82'-0" criteria are a variance under Ord. 2023-603 §1005. It would be filed as a CONCURRENT variance with the rezoning and decided by Mayor and Council with the companion application (§1005-1); no variance may be approved before the Council's final action on the rezoning. NO OTHER RELIEF IS REQUESTED: lot area 4,100 SF (1,000 SF minimum), lot width 50'-0" (50 ft minimum), density 4.34 du/acre (8 maximum), front setback 15 ft, side 5 ft, rear 20 ft, height one story — each appears consistent with Table 4.1 as drawn. The applicant's responses to the §1005-3.2 criteria are tabulated at the left and keyed (a) — (g) on the plan.
- THE §1005-3.2 CRITERIA TEXT IS NOT REPRODUCED HERE — VERIFY. The excerpt set the package works from (disturbance-excepting) end inside §1005-3.1, so the adopted wording of the criteria at §1005-3.2(a) through (g) has not been transcribed from a primary source. The criterion subjects shown are the standard Georgia hardship-variance subjects and the letters are placeholders. Before filing, transcribe §1005-3.2(a)–(g) verbatim from Ord. 2023-603 and confirm each response — and its letter — to the adopted text.
- THE 82'-0" DIMENSION IS ARITHMETIC. With available at the first lot (u = 230) = 235.88 ft, less two 20'-0" buffer tracts (40.0 ft), less the 31'-0" minimum private-lane tract (22'-0" pavement + 2'-0" strip + 5'-0" sidewalk + 2'-0" strip) = 164.88 ft for two facing rows, i.e. 82.44 ft each. The lot module is set at 82'-0" and the surplus within that the strip picks up toward the rear (8 widens to 246'-5") is carried to the lane tract, exactly as it is on Sheet C-2.0. Lot depth is measured perpendicular to the front lot line; lot area is 4,100 SF on every lot computed lot by lot (4,100 – 4,100 SF).
- THE THIRD HOUSE PLAN. Body depth available on an 82-ft lot = 82' – 15' (front setback) = 20' (rear setback) = 47'-0", less the 6'-0" covered porch = 41'-0". Plan A "The Springfield" has a 31'-0" body and Plan B "The Laurel" 37'-0" (disabilities) only, so NEITHER FITS. Plan C is drawn as a SCHEMATIC one-story 38'-0" × 41'-0" body with the same front-facing garage, an integral 6'-0" covered porch and a 2-car garage matching 5'-0" behind the rear wall (Table 4.2 design criterion) — 1,012 SF conditioned, 441 SF garage, 102 SF covered porch, 1,555 SF total under roof. That is 12 SF above the 1,000-SF minimum heated floor area for a cottage home in Table 4.1 — about 1%. Plan C carries no covered rear porch or a grade-uncovered patio is shown dashed in the 20-ft rear yard and its permeability must be confirmed. Plan C is a BLOCK DIAGRAM, NOT A DESIGNED PLAN. It is drawn to show that a compliant cottage fits, and must be replaced by a Georgia-registered architect's drawings.
- THE PERMETER BUFFER TRACTS. Tracts B-1 (NE line, 1,722 LF), B-2 (SW line, 1,757 LF) and B-3 (rear line, 246 LF) total 73,697 SF, are 20'-0" wide and extend perpendicular to the property line, are owned and maintained by the homeowners association, and are to be shown on the final plat labeled "20' UNDISTURBED BUFFER with a no-disturbance restriction and the HOA maintenance obligation (Checklist §4.4, §6.3). No dwelling, drive or accessory structure is drawn in them. Two encroachments carried over from Sheet C-2.0 must be disclosed: (i) the existing 8-in sanitary sewer and its 20-ft easement run inside Tract B-2 for about 300 ft from Arcado Rd to the manhole at (u 272, v -224) — Checklist §6.1 permits sanitary sewer conveyance facilities and easements to encroach a buffer "as near as perpendicular as possible, up to max 50' width", which this parallel run does not satisfy, and §6.4 may require 25 ft of additional buffer outside the easement; (ii) the SW curb return at the entrance reaches 2.0 ft into the buffer band (0.1 SF). Both need (i) the Director's reading, and (ii) exists on Sheet C-2.0 as well. The SW pickelball pad stands 2.0 ft clear of Tract B-2 (22.0 ft from the property line); Checklist §6.1's 5-ft landscape strip around accessory structures would move it about 1.0 ft to the NE — an amenity-block item inherited unchanged from Sheet C-2.0.

IMPERVIOUS SCHEDULE — FALLBACK LAYOUT	AREA
Dwellings, garages and covered porches (Plan C on every lot)	63,725
Lot driveways, aprons and entry walks	29,304
Private lane pavement (27'-0" unchanged)	34,111
Entry drive pavement and curb returns (unchanged)	5,049
Hammerhead turnaround (per §313(1))	7,200
Guest and mail-kiosk parking bays (unchanged)	2,070
Sidewalks (5'-0" — the SW walk begins at u = 1090)	11,869
Clubhouse roof, court pails, mail kiosk and amenity walks (unchanged)	6,760
less driveway impervious area counted twice	-2,900
TOTAL IMPERVIOUS — 37.7% of the 417,174-SF GIS site area (Sheet C-2.0: 184,148 SF = 44.1%)	157,158

Disclaimer: This is an AI-generated analysis for preliminary planning purposes. All findings must be verified by a licensed professional before use in design, permitting, or regulatory submissions.

Label: DRAFT / NOT SEALED — every item that must be sealed by a Georgia RLS, PE, architect or landscape architect is shown as a concept only. Statements of conformity read "appears consistent with".

THE COTTAGES AT ARCADE SPRINGS

FALLBACK LOT-DEPTH LAYOUT EXHIBIT — Rezoning R-1 → R-2 (City of Lilburn, Georgia)

4535 / 4537 / 4539 / 4541 Arcado Rd SW, Lilburn, GA 30047 — Land Lot 123, 6th District, Gwinnett County — PINs R6123 033, 015, 014, 162 — 9.44 ac (deeded)

ALTERNATIVE LAYOUT — 50'-0" × 82'-0" lots, the 20-ft buffer in separate HOA tracts, and a concurrent §1005 lot-depth variance (100 ft — 82 ft)

APPLICANT / OWNER

Mohammed Awad

4541 Arcado Rd SW, Lilburn GA 30047-3968 (parcels 033, 015); Mendez / Roblero de Leon (parcels 014, 162) — co-applicants, owner signatures required

PREPARED FOR

Pre-application conference, City of Lilburn Planning & Zoning (340 Main St) — rezoning application per Ord. 2023-603 §1003 (2026 Application Instructions)

STATUS

DRAFT — NOT SEALED

ALTERNATIVE LAYOUT — NOT THE PROPOSED PLAN. The proposed plan is Sheet C-2.0 (Master Concept Plan). This exhibit applies only if staff require the 20-ft buffer in a separate tract; it then carries a concurrent §1005 variance on lot depth (100 ft — 82 ft) and a third house plan, Plan C.

Generator: tools/sitebase.py + tools/fallback.py

DATE

2026-09-03

SCALE

Scale 1" = 60' (ARCH D 36 × 24 in); details 1" = 20' and 3/32" = 1'-0"

DATUM

SR 2240 GA West US-ft; NAVD88

DRAWN

owner-prepared (AI-assisted)

CHECKED

RLS / PE — pending

SHEET

C-2.4

FALLBACK LOT-DEPTH LAYOUT EXHIBIT